


255 45' 760 1360

COLORADO

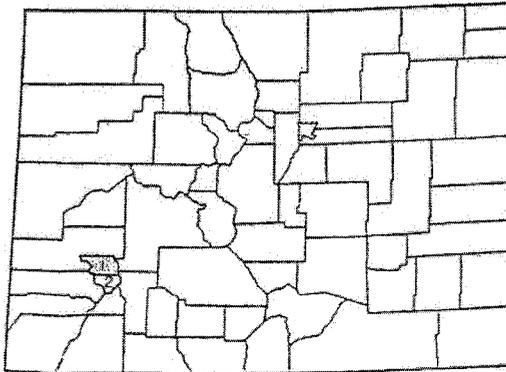


LOCATION DIAGRAM

1/4 MILES

EET

- Perennial
- Intermitte
- Public par
- National a
- or game la
- Other pub
- Military or

1/4

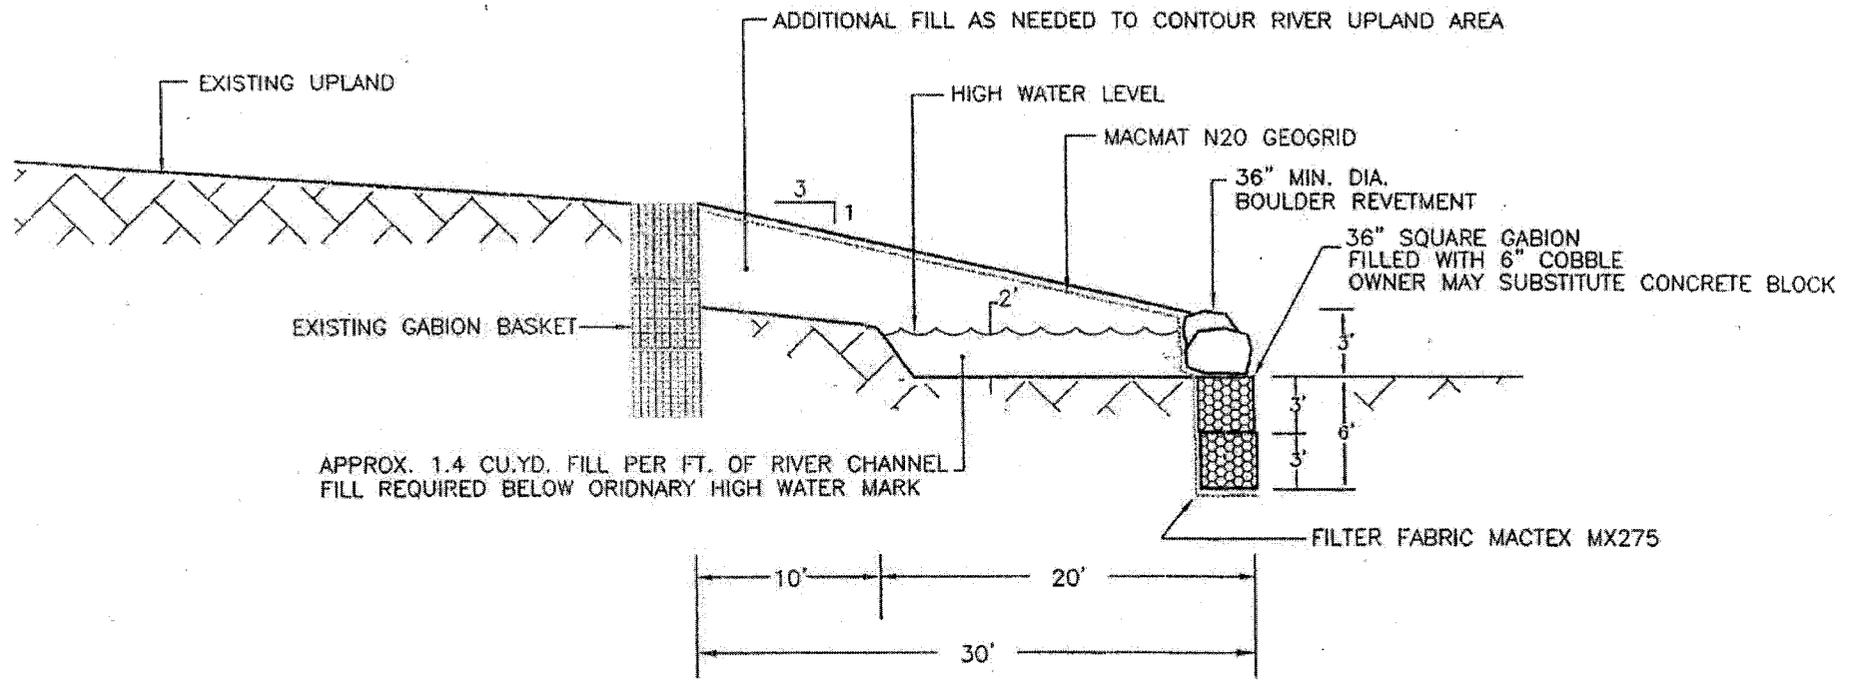

SECTION 1

SCALE 1" = 10'

2/4

UPLAND NATIVE GRASS
WHEATGRASS OR WILD RYE

SAND WILLOW SHOOTS PLACED BETWEEN
BOULDERS, ENDS SHOULD CONTACT
PLACEMENT SHALL OCCUR WHEN FILL IS PLACED
AVE. SHOOT LENGTH = 5'


36" MIN. DIA.
BOULDER REVETMENT

AREA OF FILL

2'

RIVER BED


ROCK FILLED GABION

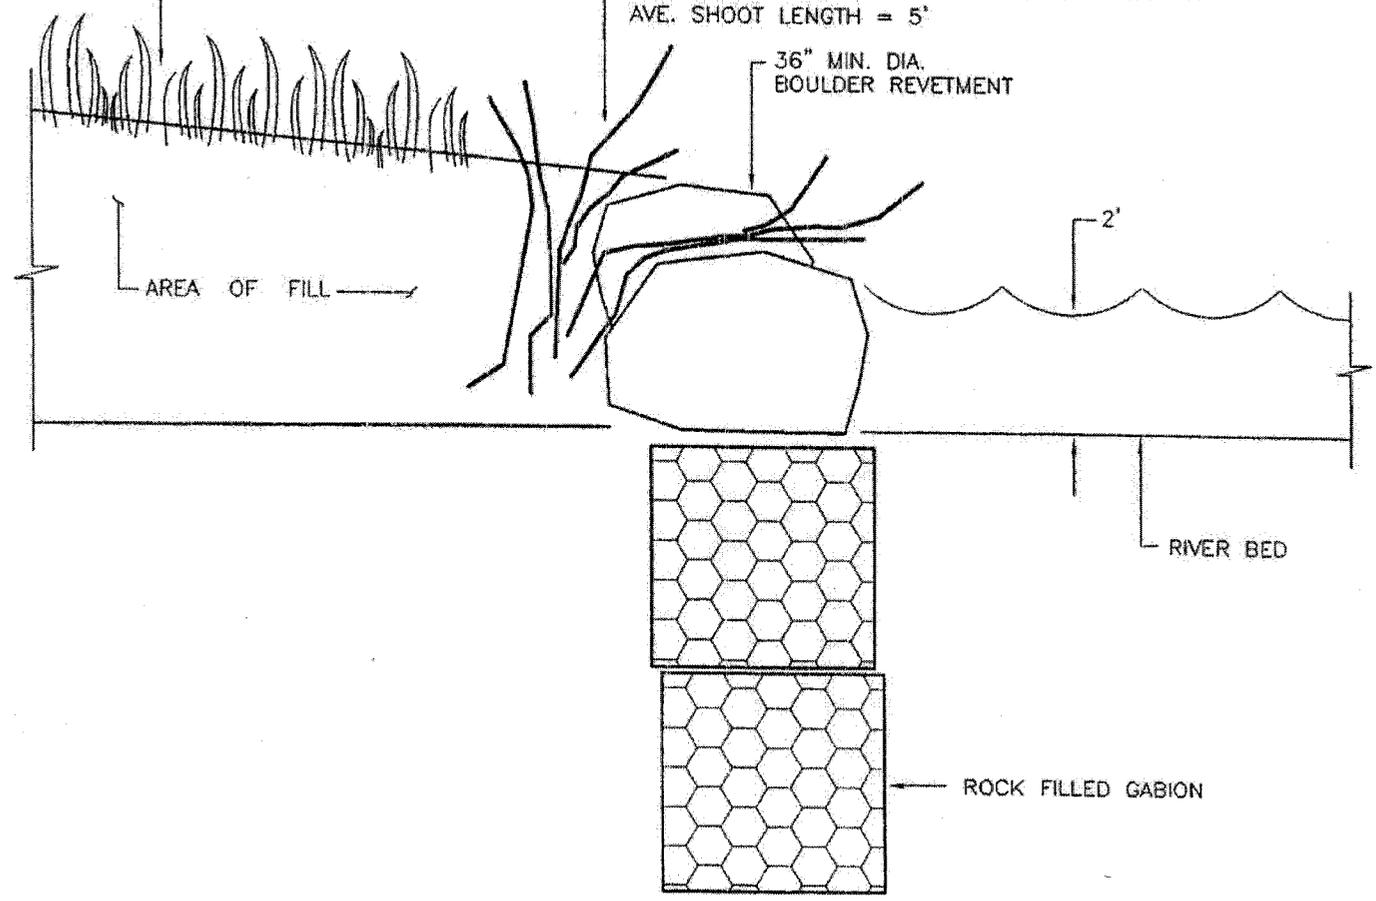

REVEGETATION PLAN

NOT TO SCALE

3/4

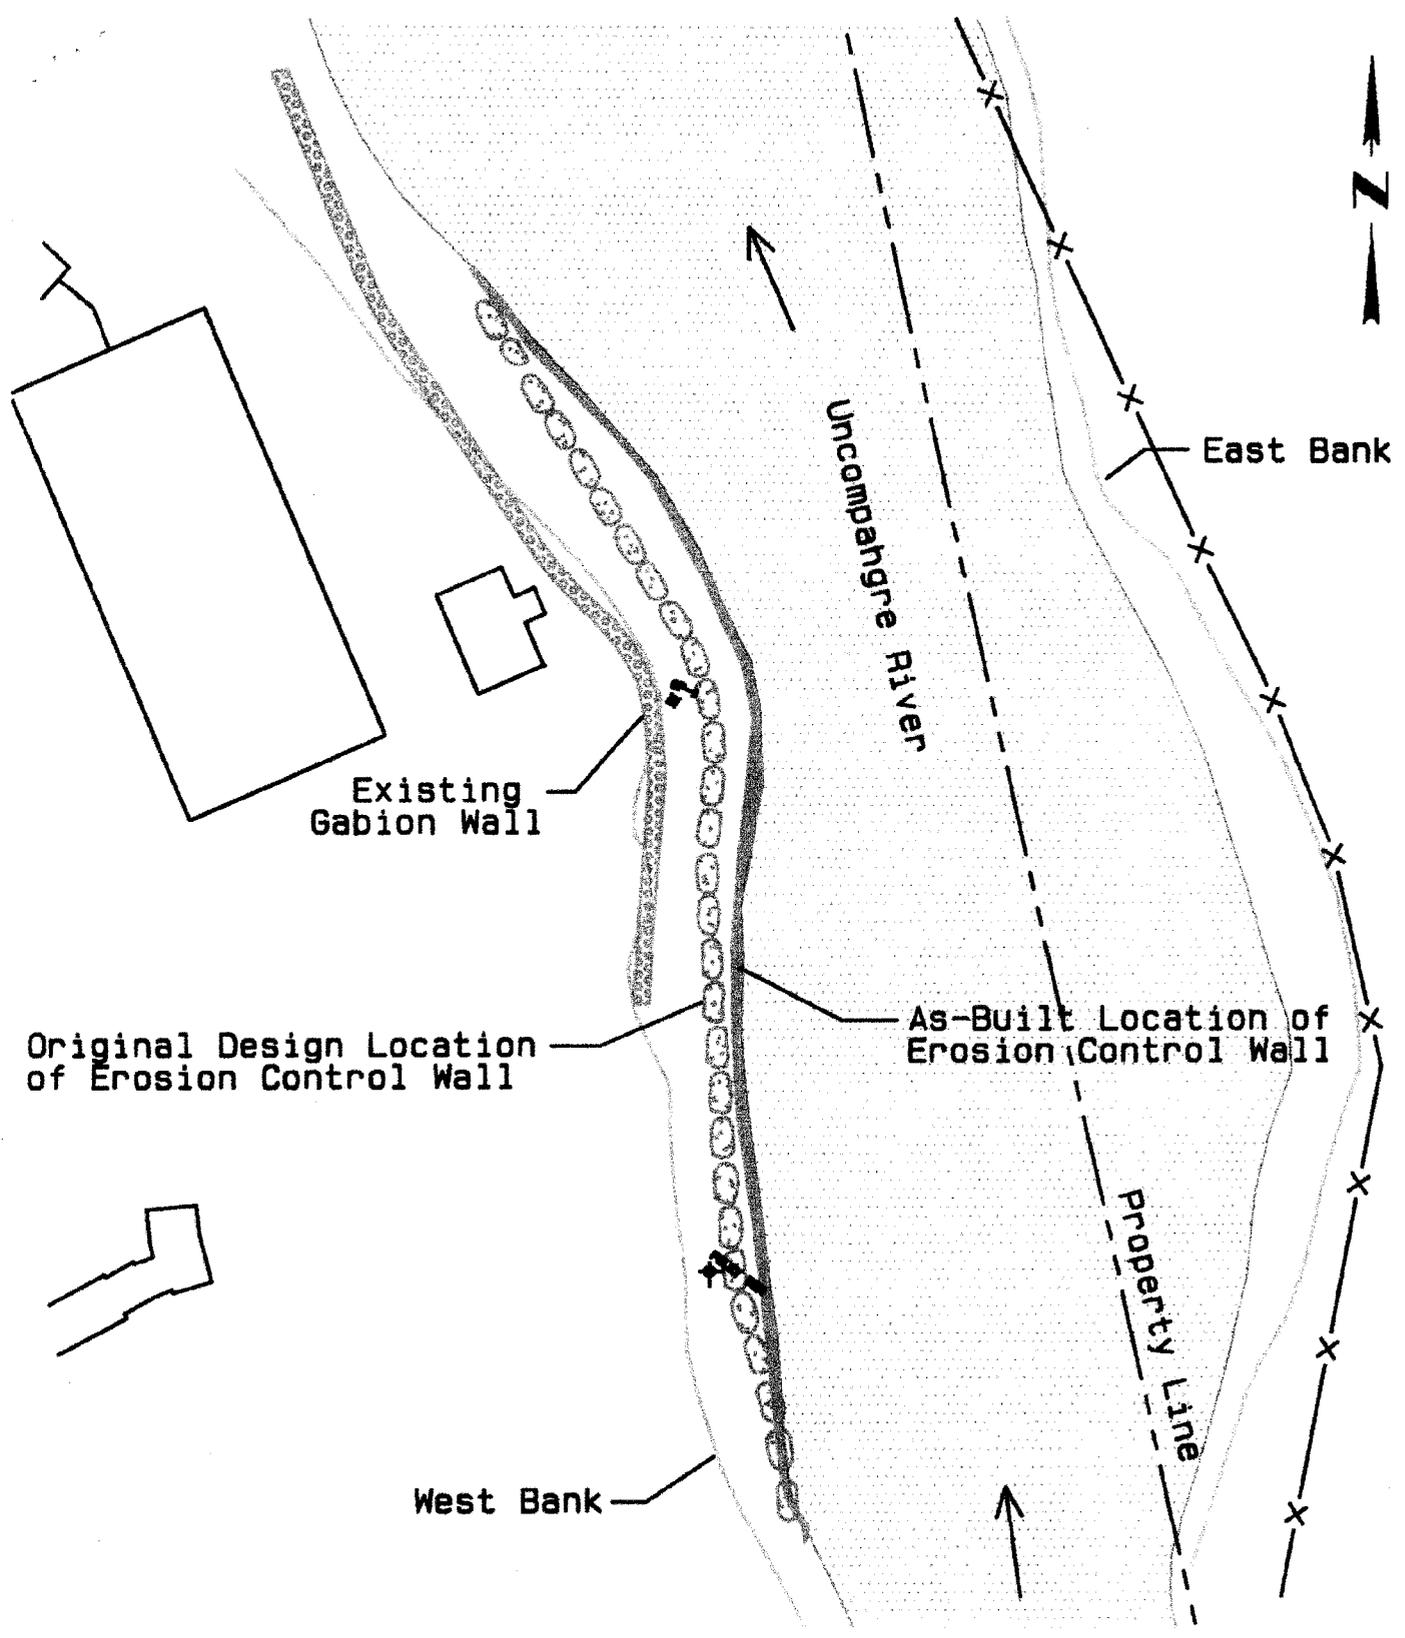

Original Design Location of Erosion Control Wall

Existing Gabion Wall

Uncompahgre River

East Bank

As-Built Location of Erosion Control Wall

Property Line

West Bank