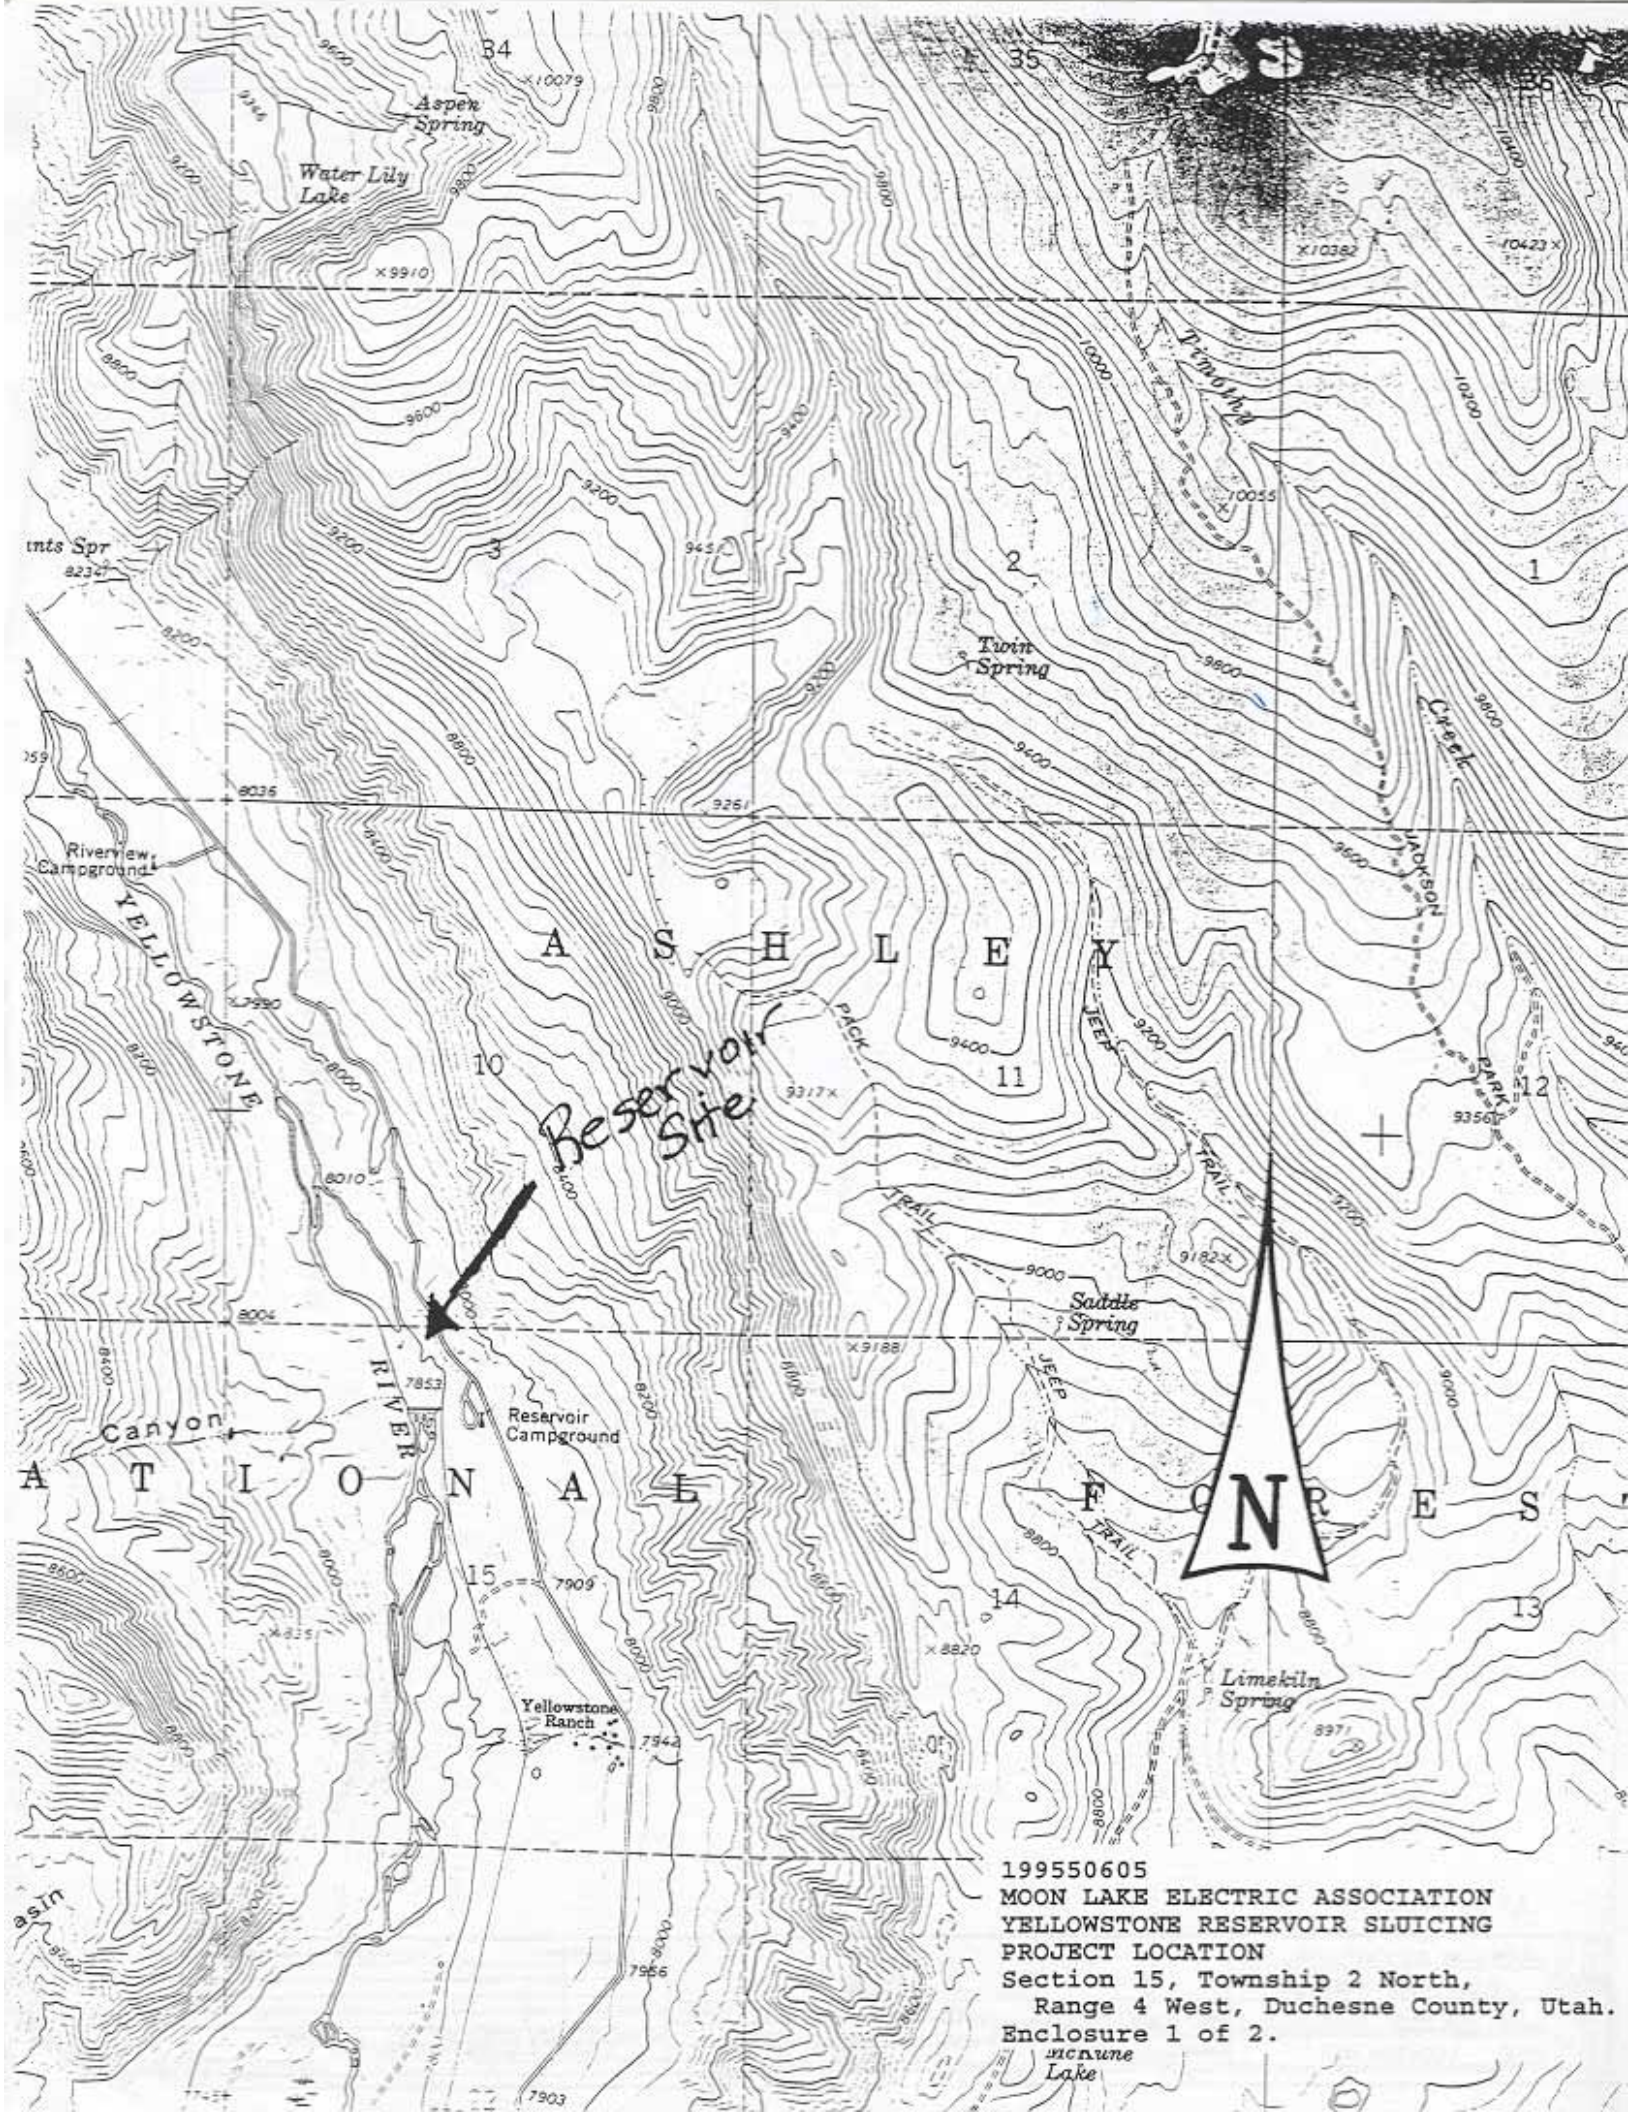

199550605
MOON LAKE ELECTRIC ASSOCIATION
YELLOWSTONE RESERVOIR SLUICING
PROJECT LOCATION
Section 15, Township 2 North,
Range 4 West, Duchesne County, Utah.
Enclosure 1 of 2.

YELLOWSTONE RESERVOIR & DAM

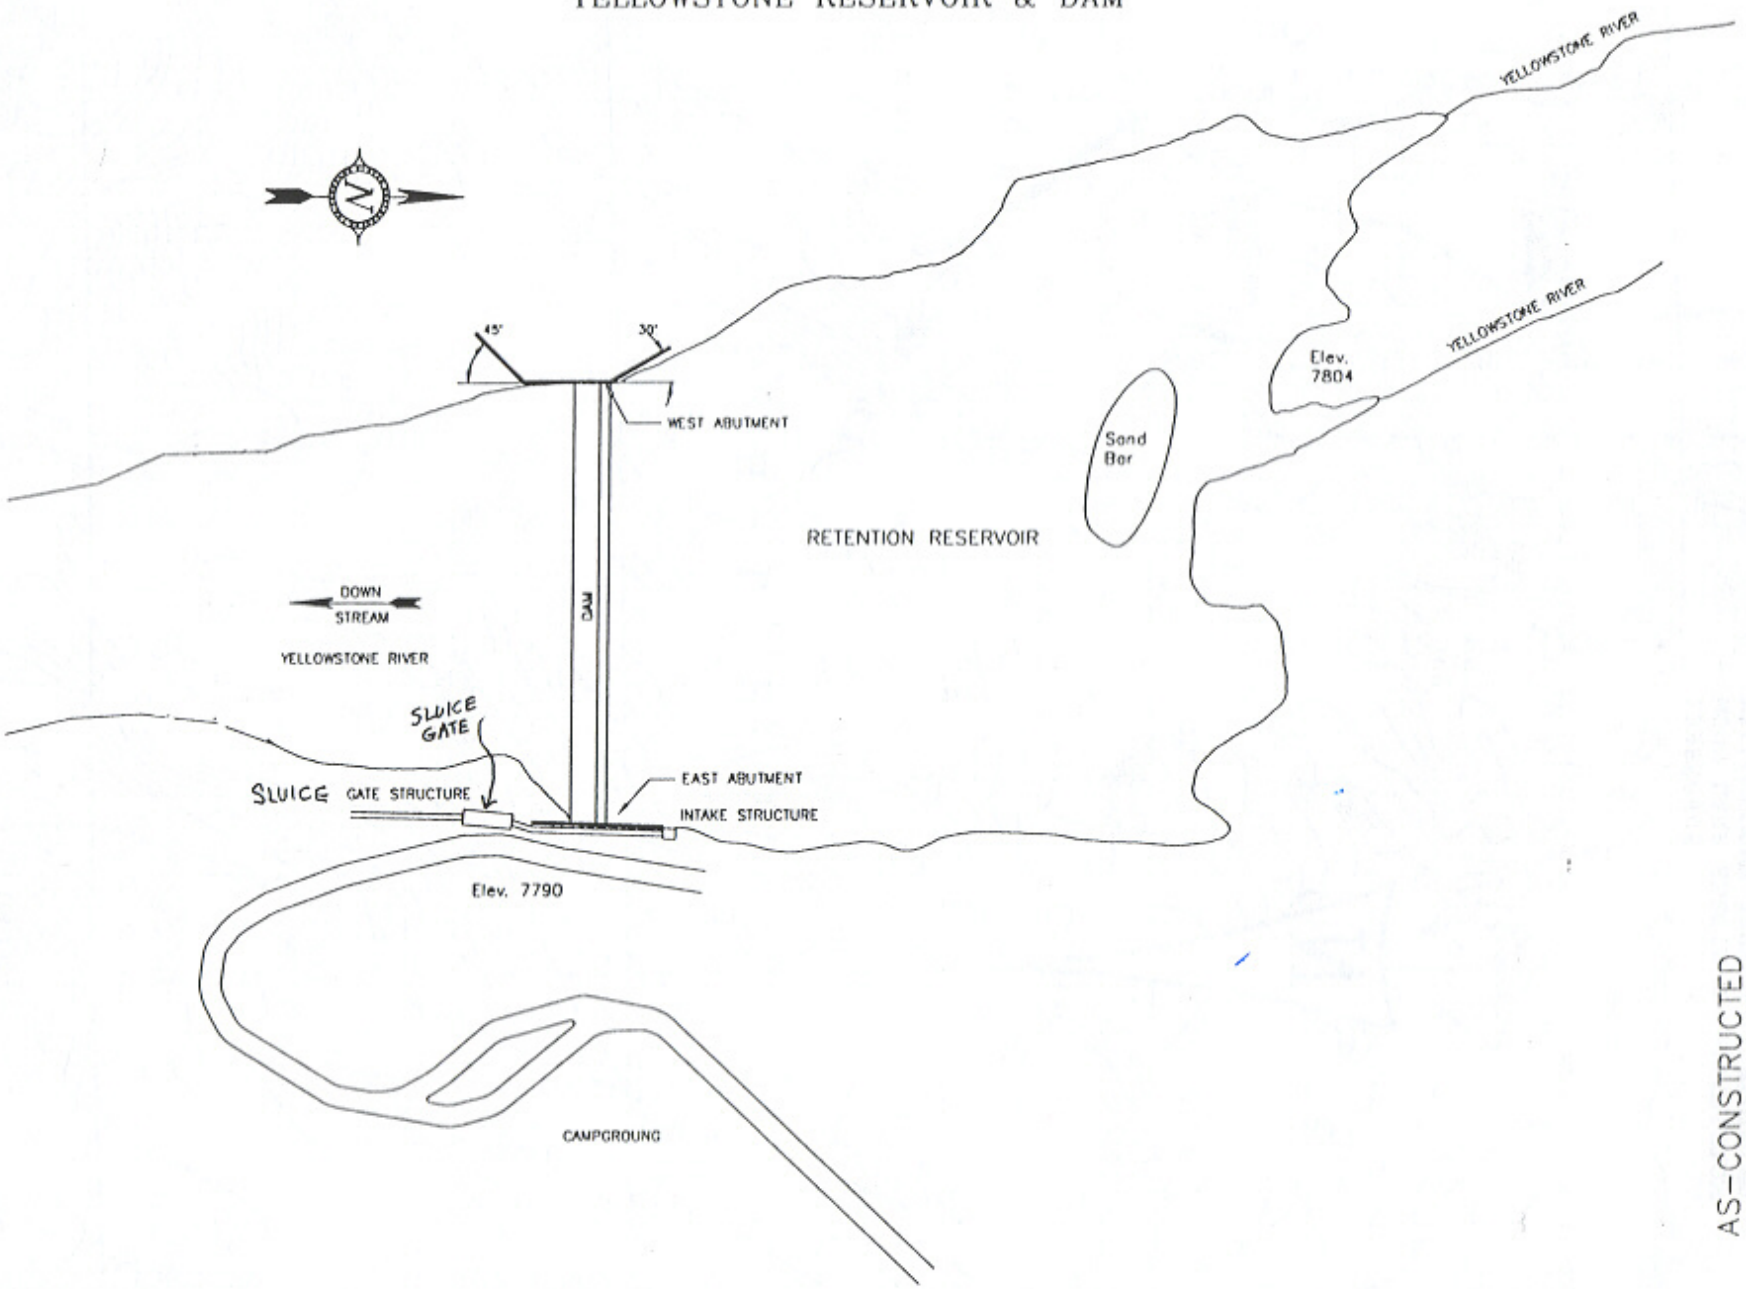

AS-CONSTRUCTED

Uintah Engineering, Inc.
ENGINEERING CONSULTANTS

MOON LAKE ELECTRIC ASSN., INC.
YELLOWSTONE RESERVOIR
DAM ABUTMENT RENOVATION
LOCATION MAP

DUCHESNE COUNTY
EXHIBIT F1-A

199550605
YELLOWSTONE RESERVOIR SLUICING
SITE PLAN
Enclosure 2 of 2.